WE, THE UNDERSIGNED, HEREBY CERTIFY THAT WE ARE THE OWNERS OF, OR HAVE INTEREST IN, THE LAND INCLUDED WITHIN THIS SUBDIVISION ENTITLED TRACT NO. 1967-2 SHOWN ON THIS MAP, CONSISTING OF 11 SHEETS, AND THAT WE ARE THE ONLY PERSON(S) WHOSE CONSENT IS NECESSARY TO PASS A CLEAR TITLE TO SAID LAND AND CONSENT TO THE MAKING AND RECORDATION OF SAID MAP AND SUBDIVISION AS SHOWN WITHIN THE COLORED BORDERLINE, AND DO HEREBY OFFER TO DEDICATE TO THE CITY OF THOUSAND OAKS, FREE AND CLEAR OF ANY PRIOR EASEMENTS OF RIGHT-OF-WAY, FOR PUBLIC USE, THE RIGHT-OF-WAY FOR ALL STREETS AND HIGHWAYS, PUBLIC SERVICE EASEMENTS, EASEMENTS FOR STREET PURPOSES, AND STORM DRAIN EASEMENTS AS SHOWN ON THIS MAP. WE ALSO HEREBY OFFER TO DEDICATE TO THE CITY OF THOUSAND OAKS THE ONE FOOT NON-VEHICULAR ACCESS STRIPS SHOWN ON THIS MAP AS PARCELS A, B, C AND D. WE ALSO HEREBY OFFER TO DEDICATE TO THE CITY OF THOUSAND OAKS ALL RIGHTS OF INGRESS AND EGRESS OVER AND ACROSS THE WESTERLY LINES OF LOT 538, ABUTTING BROOMFIRTH COURT AND DEWBERRY COURT, THE WESTERLY LOT LINES OF LOTS 535, 454 THRU 462, INCLUSIVE AND THE NORTHERLY LOT LINES OF LOTS 463 THRU 467 AND LOT 537 AND THE SOUTHERLY LOT LINE OF LOT 538, ABUTTING S. TRIUNFO CANYON ROAD, THE WESTERLY, SOUTHERLY AND SOUTHEASTERLY LOT LINES OF LOT 537 ABUTTING SANDPIPER CIRCLE, GARDENSTONE COURT AND ROSEBAY STREET, RESPECTIVELY, THE SOUTHEASTERLY LOT LINE OF LOT 540 ABUTTING SOREELWOOD COURT, THE WESTERLY AND EASTERLY LOT LINES OF LOT 539 ABUTTING NETTLEBROOK STREET AND LINDENGROVE STREET, RESPECTIVELY, THE EASTERLY LOT LINE OF LOT 543 AND THE WESTERLY LOT LINE OF LOT 542 ABUTTING HARTGLEN AVENUE, THE NORTHERLY AND SOUTHEASTERLY LOT LINES OF LOT 542 ABUTTING BASSWOOD COURT AND LINDENGROVE STREET, RESPECTIVELY, AND THE EASTERLY LOT LINE OF LOT 544 ABUTTING GLENHOLLOW STREET, SO THAT THE OWNERS OF SAID LOTS SHALL HAVE NO ACCESS WHATSOEVER TO BROOMFIRTH COURT, DEWBERRY COURT, S. TRIUNFO CANYON ROAD, SANDPIPER CIRCLE, GARDENSTONE COURT, ROSEBAY STREET, SOREELWOOD COURT, NETTLEBROOK STREET, LINDENGROVE STREET, HARTGLEN AVENUE, BASSWOOD COURT AND GLENHOLLOW STREET EXCEPT IN THE GENERAL EASEMENT OF TRAVEL, WHICH BELONGS TO THE WHOLE PUBLIC. WE ALSO HEREBY OFFER TO DEDICATE TO THE CITY OF THOUSAND OAKS THE DEVELOPMENT RIGHTS FOR LOTS 535, 536, 537, 538, 539, 540, 541, 542, 543 AND 544. WE ALSO HEREBY OFFER TO DEDICATE TO THE CITY OF THOUSAND OAKS AN EASEMENT FOR MAINTENANCE PURPOSES OVER LOTS 535, 536, 537, 538, 539, 540, 541, 542, 543 AND 544. WE ALSO HEREBY OFFER TO DEDICATE TO THE CITY OF THOUSAND OAKS EASEMENTS FOR PEDESTRIAN AND VEHICULAR TRAFFIC PURPOSES OVER LOTS 535, 536, 537, 538, 539, 540, 541, 542, 543 AND 544. WE ALSO HEREBY OFFER TO DEDICATE TO THE TRIUNFO COUNTY SANITATION DISTRICT ALL OF THE SEWER EASEMENTS AS SHOWN ON THIS MAP. WE ALSO HEREBY OFFER TO DEDICATE TO THE CONEJO RECREATION AND PARK DISTRICT LOT NO. 534, FOR PARK PURPOSES.

WESTLAKE VILLAGE, A PARTNERSHIP

BY: AMERICAN-HAWAIIAN STEAMSHIP COMPANY, A NEW JERSEY CORPORATION, A PARTNER

BY: Joseph M. Bowman Asst V.P., PRESIDENT

BY: [signature] Asst SECRETARY

STATE OF CALIFORNIA } S.S.
COUNTY OF VENTURA }

ON THIS 25th DAY OF June IN THE YEAR 1969, BEFORE ME, THE UNDERSIGNED, A NOTARY PUBLIC IN AND FOR SAID STATE, PERSONALLY APPEARED Joseph M. Bowman, KNOWN TO ME TO BE THE Assistant Vice PRESIDENT, AND [illegible] KNOWN TO ME TO BE THE Assistant SECRETARY OF AMERICAN-HAWAIIAN STEAMSHIP COMPANY, THE CORPORATION THAT EXECUTED THE WITHIN INSTRUMENT AND KNOWN TO ME TO BE THE PERSONS WHO EXECUTED THE WITHIN INSTRUMENT ON BEHALF OF SAID CORPORATION, SAID CORPORATION BEING KNOWN TO ME TO BE ONE OF THE PARTNERS OF WESTLAKE VILLAGE, THE PARTNERSHIP THAT EXECUTED THE WITHIN INSTRUMENT, AND ACKNOWLEDGE TO ME THAT SUCH CORPORATION EXECUTED THE SAME AS SUCH PARTNER AND THAT SUCH PARTNERSHIP EXECUTED THE SAME.

WITNESS MY HAND AND OFFICIAL SEAL.

Doris M. Majneric
DORIS M. MAJNERIC
My Commission Expires Oct. 15, 1970

OFFICIAL SEAL
DORIS M. MAJNERIC
NOTARY PUBLIC - CALIFORNIA
PRINCIPAL OFFICE IN
VENTURA COUNTY

TITLE INSURANCE AND TRUST COMPANY, a California Corporation, (Trustee) under deed of trust recorded in Book 2997, Page 527 of Official Records.

By Alden Gray Assistant Secretary

State of California } ss.
County of Ventura }

On this 25TH day of JUNE in the year 1969, before me, the undersigned, a Notary Public in and for said County and State, personally appeared ALDEN GRAY, known to me to be the Assistant Secretary of TITLE INSURANCE AND TRUST COMPANY, the corporation that executed the within instrument and known to me to be the person who executed the within instrument on behalf of the corporation therein named and acknowledged to me that such corporation executed the within instrument, as trustee, pursuant to its by-laws or a resolution of its board of directors.

Norma J. Poush
NOTARY PUBLIC
My Commission Expires 1/7 1973

OFFICIAL SEAL
NORMA J. POUSH
NOTARY PUBLIC, CALIFORNIA
PRINCIPAL OFFICE IN
VENTURA COUNTY
My Commision Expires Jan. 7, 1973

#64585

Recorded at the request of the Owner, December 9, 1969, at 11:00 A.M. in Book 54 of Miscellaneous Records (Maps) at Pages 1-11 INC, records of Ventura County.

ROBERT L. HAMM
County Recorder
County of Ventura

By Lucille Sargent
Deputy County Recorder

I, C. R. NELSON, do hereby certify that I am a REGISTERED CIVIL ENGINEER, that this map correctly represents a survey made under my direction in OCTOBER 1968, that the survey is true and complete as shown, that the monuments are of the character and occupy the positions indicated, (or will be set in such positions within one year after approval of this tract map) and that they are (or will be) sufficient to enable the survey to be retraced. Tie notes to all centerline monuments shown hereon as set by me will be on file in the office of the City Engineer prior to acceptance of the improvements into the City Street System.

Date Oct. 14 1968 C. R. Nelson
REGISTERED CIVIL ENGINEER NO. 8781.

I certify that according to the records of my office there are no liens against the subdivision TRACT NO. 1967-2, or any part thereof for unpaid state, county, municipal, or local taxes or special assessments collected as taxes, except taxes or special assessments not yet payable.

Date June 25 1969

RAYMOND S. WALKER
Treasurer — Tax Collector
County of Ventura

By Blanche Wiles
Deputy Tax Collector

I certify that I have examined the final map entitled TRACT NO. 1967-2, that the subdivision is substantially the same as it appeared on the tentative map, and any approved alterations thereof, that all provisions of Chapter 2, Division 4, Part 2, of the Business and Professions Code of the State of California and of any local ordinance applicable at the time of approval of the tentative map have been complied with and that I am satisfied that the map is technically correct.

Date 12-4 1969 T. William Hale
T. WILLIAM HALE
CITY ENGINEER, CITY OF THOUSAND OAKS

I certify that all the provisions of Chapter 2, Division 4, Part 2, of the Business and Professions Code of the State of California and of any local ordinance pertaining to deposits, required at the time of the approval by the Board of Supervisors of the map entitled TRACT NO. 1967-2, have been complied with.

Date December 8 1969 Robert L. Hamm
ROBERT L. HAMM
County Clerk
County of Ventura

By _____
Deputy County Clerk

I, VELMA S. QUINN, CITY CLERK OF THE CITY OF THOUSAND OAKS, COUNTY OF VENTURA, STATE OF CALIFORNIA, CERTIFY THAT ALL PROVISIONS OF CHAPTER 2, DIVISION 4, PART 2, OF THE BUSINESS AND PROFESSIONS CODE OF THE STATE OF CALIFORNIA AND OF ANY LOCAL ORDINANCE PERTAINING TO DEPOSITS REQUIRED AT THE TIME OF APPROVAL BY THE CITY COUNCIL OF THE CITY OF THOUSAND OAKS, OF THE MAP ENTITLED TRACT NO. 1967-2 HAVE BEEN COMPLIED WITH.

DATED Dec. 5th 1969.

VELMA S. QUINN
CITY CLERK
CITY OF THOUSAND OAKS

Velma S. Quinn
CITY CLERK

I HEREBY CERTIFY THAT THE CITY COUNCIL OF THE CITY OF THOUSAND OAKS, ON THE 2nd DAY OF DEC. 1969, APPROVED THE ATTACHED MAP AND ALSO ACCEPTED ALL RIGHTS OF INGRESS AND EGRESS AS OFFERED, AND THE ONE FOOT NON-VEHICULAR ACCESS STRIPS SHOWN AS PARCELS A, B, C AND D ON THE MAP, AND ALSO ACCEPTED ON BEHALF OF THE PUBLIC, FOR PUBLIC USE THE RIGHT-OF-WAY FOR ALL STREETS AND HIGHWAYS, PUBLIC SERVICE EASEMENTS AND STORM DRAIN EASEMENTS AS SHOWN ON THE MAP. THE OFFER OF DEDICATION OF MAINTENANCE EASEMENTS, DEVELOPMENT RIGHTS AND PEDESTRIAN AND VEHICULAR TRAFFIC EASEMENTS WAS REJECTED.

DATED Dec. 5th 1969.

VELMA S. QUINN
CITY CLERK
CITY OF THOUSAND OAKS

Velma S. Quinn
CITY CLERK

THE TRIUNFO COUNTY SANITATION DISTRICT HEREBY ACCEPTS FOR PUBLIC USE, ALL SANITARY SEWER EASEMENTS DELINEATED AND DESIGNATED UPON THE MAP, WHEN SAID MAP IS APPROVED AND RECORDED.

TRIUNFO COUNTY SANITATION DISTRICT

DATED Aug 12 1969

John T. Conlin
CHAIRMAN OF THE BOARD

The following soil reports have been prepared on TRACT NO. 1967-2:

Date of Report	Title of Report	Firm Name	Engineer	Engineers Registration No.
1- JUNE 16, 1967	WESTLAKE DEVELOPMENT "B", POTRERO VALLEY AREA, ALBERTSON RANCH, VENTURA CO., CALIF. (TR. 1967-2)	GEOLABS, INC.	RONALD J. LEMAN	R.C.E. 16564.
2- AUG. 9, 1968	GRADING PLAN REVIEW WITH GEOLOGIC EXPLORATIONS AND SLOPE STABILITY ANALYSIS, (TR. 1967-2) ALSO ADDENDUM DATED AUG. 19, 1968	GEOLABS, INC.	GARY E. RITTENHOUSE	R.C.E. 13812.
3- MAY 1, 1969,	GRADING MEMO TRACT 1967-2	GEOLABS INC.	G. S. KOVACS	R.C.E. 13503
4- MAY 27, 1969,	BUTTRESS BEHIND LOTS 261-265 & 268 TR. 1967-2	GEOLABS INC.	G. S. KOVACS	R.C.E. 13503
5- JULY 22, 1969,	STRUCTURAL PAVING, SECTIONS TR. 1967-2	GEOLABS INC.	G. S. KOVACS	R.C.E. 13503
6- OCT. 27, 1969,	APPROVAL OF STRUCTURAL PAVING SECTIONS TR. 1967-2	CITY OF THOUSAND OAKS	LEE WORTH	

I KNOW NO OTHER SOIL REPORT PREPARED FOR TRACT NO. 1967-2

DATED Dec. 4 1969

C. R. NELSON R.C.E. 8781

The signature of WESTLAKE COMMUNICATIONS, INC., (Easement Owner) has been omitted under the provisions of Section 11587, Subsection (a) of the Business and Professions Code, as their interests cannot ripen into a fee.

The signature of Buena Tierra Development Company, a Delaware Corporation, present owner of all oil, gas and other hydrocarbon substances lying within and under that portion of said land lying below a depth of 500 feet, measured vertically, from the surface of said land, without, however, any right to enter upon the surface of said land nor into that portion of the Subsurface thereof, lying above a depth of 500 feet, measured vertically from said surface, has been omitted under the provisions of Section 11587, Subsection (c-1) of the Business and Professions Code, inasmuch as such ownership does not include a right of entry on the surface of the land.

TRACT NO. 1967-2

IN THE CITY OF THOUSAND OAKS,
COUNTY OF VENTURA,
STATE OF CALIFORNIA.

BEING A SUBDIVISION OF PORTIONS OF SECTION 23, T.1N., R.19W., IN THE RANCHO EL CONEJO, AS SHOWN ON A MAP ENTITLED "MAP OF PARTITION SURVEY OF RANCHO EL CONEJO, VENTURA COUNTY, CALIFORNIA," RECORDED IN BOOK 1, PAGE 746, OF DEEDS, IN THE OFFICE OF THE RECORDER OF SAID COUNTY.

VOORHEIS-TRINDLE CO.
VAN NUYS, CALIF.
OCT., 1968

NOTE:
SEE SHEET 2 FOR ADDITIONAL CERTIFICATE AND ACKNOWLEDGMENT.

MONUMENT NOTES :

Δ - SET VENTURA COUNTY STANDARD SURVEY MONUMENT BOX AND MONUMENT STAMPED "R.C.E. 8781" PER PLATE F-2, ADOPTED MARCH 1, 1966.

O - SET 2" IRON PIPES AT ALL ANGLE POINTS AND CHANGES IN EXTERIOR BOUNDARY, 12" BELOW FINISHED GRADE, FILLED WITH CONCRETE AND BEARING A METAL TAG STAMPED "R.C.E. 8781."

SET 1½" IRON PIPES ON STREET CENTERLINES AT B.C.'s AND E.C.'s OR P.I.'s AND CENTERLINE INTERSECTIONS, FILLED WITH CONCRETE AND BEARING A METAL TAG STAMPED "R.C.E. 8781" EXCEPT WHERE VENTURA COUNTY STANDARD MONUMENTS ARE SET. THIS NOTE ALSO APPLIES TO MONUMENTS SET OUTSIDE OF THE BLUE BORDER.

SET 1" IRON PIPES AT ALL REAR LOT CORNERS AND AT ALL ANGLE POINTS IN LOT LINES (EXCEPT EXTERIOR BOUNDARY POINTS) AT FINISHED GRADE, FILLED WITH CONCRETE AND BEARING A METAL TAG STAMPED "R.C.E. 8781".

PLACE CHISELED "X" ON CURB IN SIDEWALK ON SIDE LOT LINES PRODUCED.

ALL OTHER "SET" PIPES, AS NOTED ON THIS MAP, ARE SET FLUSH WITH THE FINISHED GRADE, FILLED WITH CONCRETE AND BEAR METAL TAGS STAMPED "R.C.E. 8781".

ALL OTHER MONUMENTS ARE AS NOTED ON THIS MAP.

SYMBOL :

(A) DENOTES A 5' WIDE PUBLIC SERVICE EASEMENT TO THE CITY OF THOUSAND OAKS FOR STREET PURPOSES, PARALLEL WITH AND ADJACENT TO THE STREET RIGHT OF WAY LINES.

SUBORDINATION AGREEMENT :

THE UNDERSIGNED HEREBY AGREES THAT THE EASEMENTS HELD BY HIM SHALL, AS THEY AFFECT THE PUBLIC STREETS OFFERED FOR DEDICATION AND SHOWN ON THE FINAL SUBDIVISION MAP OF TRACT NO. 1967-2, BE SUBORDINATE TO THE INTEREST AND ESTATE OF THE CITY OF THOUSAND OAKS. SUCH SUBORDINATION SHALL NOT OPERATE TO SUBORDINATE ANY RIGHTS OF THE UNDERSIGNED TO ANY RIGHT WHATSOEVER OF ANY PUBLIC DISTRICT OR AGENCY (EXCEPT THE CITY OF THOUSAND OAKS) OR ANY PERSON OR ENTITY HOLDING A FRANCHISE OR ANY OTHER PERSON OR ENTITY WHATSOEVER.

WESTLAKE COMMUNICATIONS, INC., a corporation, easement holder.

By A. J. DIETSCH Vice President By JIMMY D. JOHNSON Assistant Secretary

BASIS OF BEARINGS :

THE BEARING OF N. 19° 45' 00" W. OF THE CENTERLINE OF S. TRIUNFO CANYON ROAD AS SHOWN ON MAP OF TRACT NO. 1967-1, RECORDED IN BOOK 49, PAGES 67 TO 76 INCLUSIVE, OF MISCELLANEOUS RECORDS, IN THE OFFICE OF THE RECORDER OF THE COUNTY OF VENTURA, WAS USED AS THE BASIS OF BEARINGS FOR THIS MAP.

LEGEND :

R. - INDICATES RECORD.
C. - INDICATES CALCULATED.
M. - INDICATES MEASURED.
C.F.R. - INDICATES CALCULATED FROM RECORD.

State of California } ss.
County of Orange / Los Angeles

On this 25th day of June 1969, before me THE UNDERSIGNED, a Notary Public in and for said County and State, personally appeared A.J. DIETSCH, Known to me to be the Vice President and JIMMY D. JOHNSON, to me to be the Assistant Secretary of WESTLAKE COMMUNICATIONS, INC., the corporation that executed the within instrument and known to me to be the persons who executed the within instrument on behalf of the corporation therein named and acknowledged to me that said corporation executed the same.

WITNESS MY HAND AND OFFICIAL SEAL.


OFFICIAL SEAL
JANET R. OSGOOD
NOTARY PUBLIC-CALIFORNIA
ORANGE COUNTY
My Comm. Expires Apr. 29, 1972


Janet R. Osgood
NOTARY PUBLIC
My Commission Expires April 29 1972

CONEJO RECREATION AND PARKS DISTRICT HEREBY ACCEPTS, FOR PUBLIC PARK PURPOSES, LOT NO. 534 AS SHOWN ON SHEET NO. 11 HEREIN, SUBJECT TO THE CONDITION PRECEDENT THAT THE CITY COUNCIL OF THE CITY OF THOUSAND OAKS APPROVES THE FINAL MAP OF TRACT NO. 1967-2.

DATED Nov. 6, 1969

Secretary to THE BOARD OF DIRECTORS

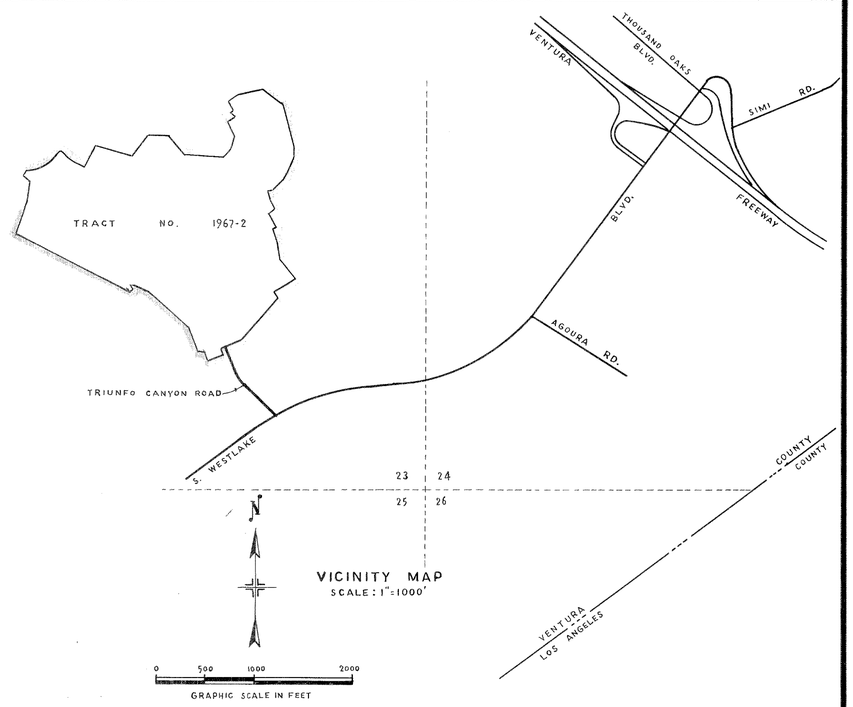

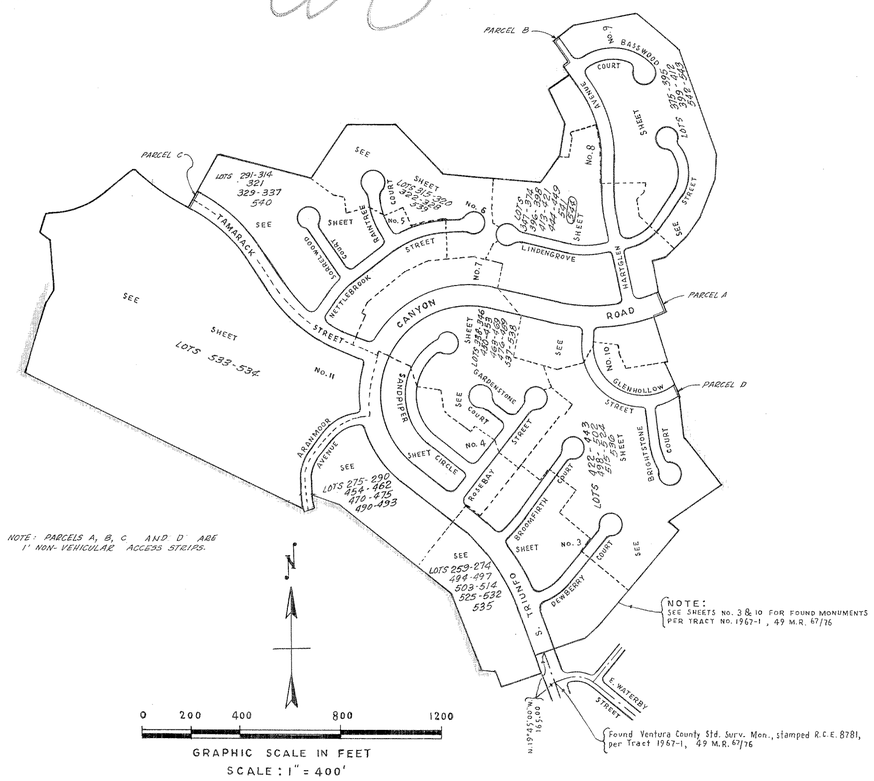


SURVEY AND KEY MAP

TRACT NO. 1967-2

IN THE CITY OF THOUSAND OAKS,
COUNTY OF VENTURA,
STATE OF CALIFORNIA.

BEING A SUBDIVISION OF PORTIONS OF SECTION 23, T.1N., R.19W., IN THE RANCHO EL CONEJO, AS SHOWN ON A MAP ENTITLED "MAP OF PARTITION SURVEY OF RANCHO EL CONEJO, VENTURA COUNTY, CALIFORNIA," RECORDED IN BOOK I, PAGE 746, OF DEEDS, IN THE OFFICE OF THE RECORDER OF SAID COUNTY.

VOORHEIS-TRINDLE CO.
VAN NUYS, CALIF.
OCT., 1968

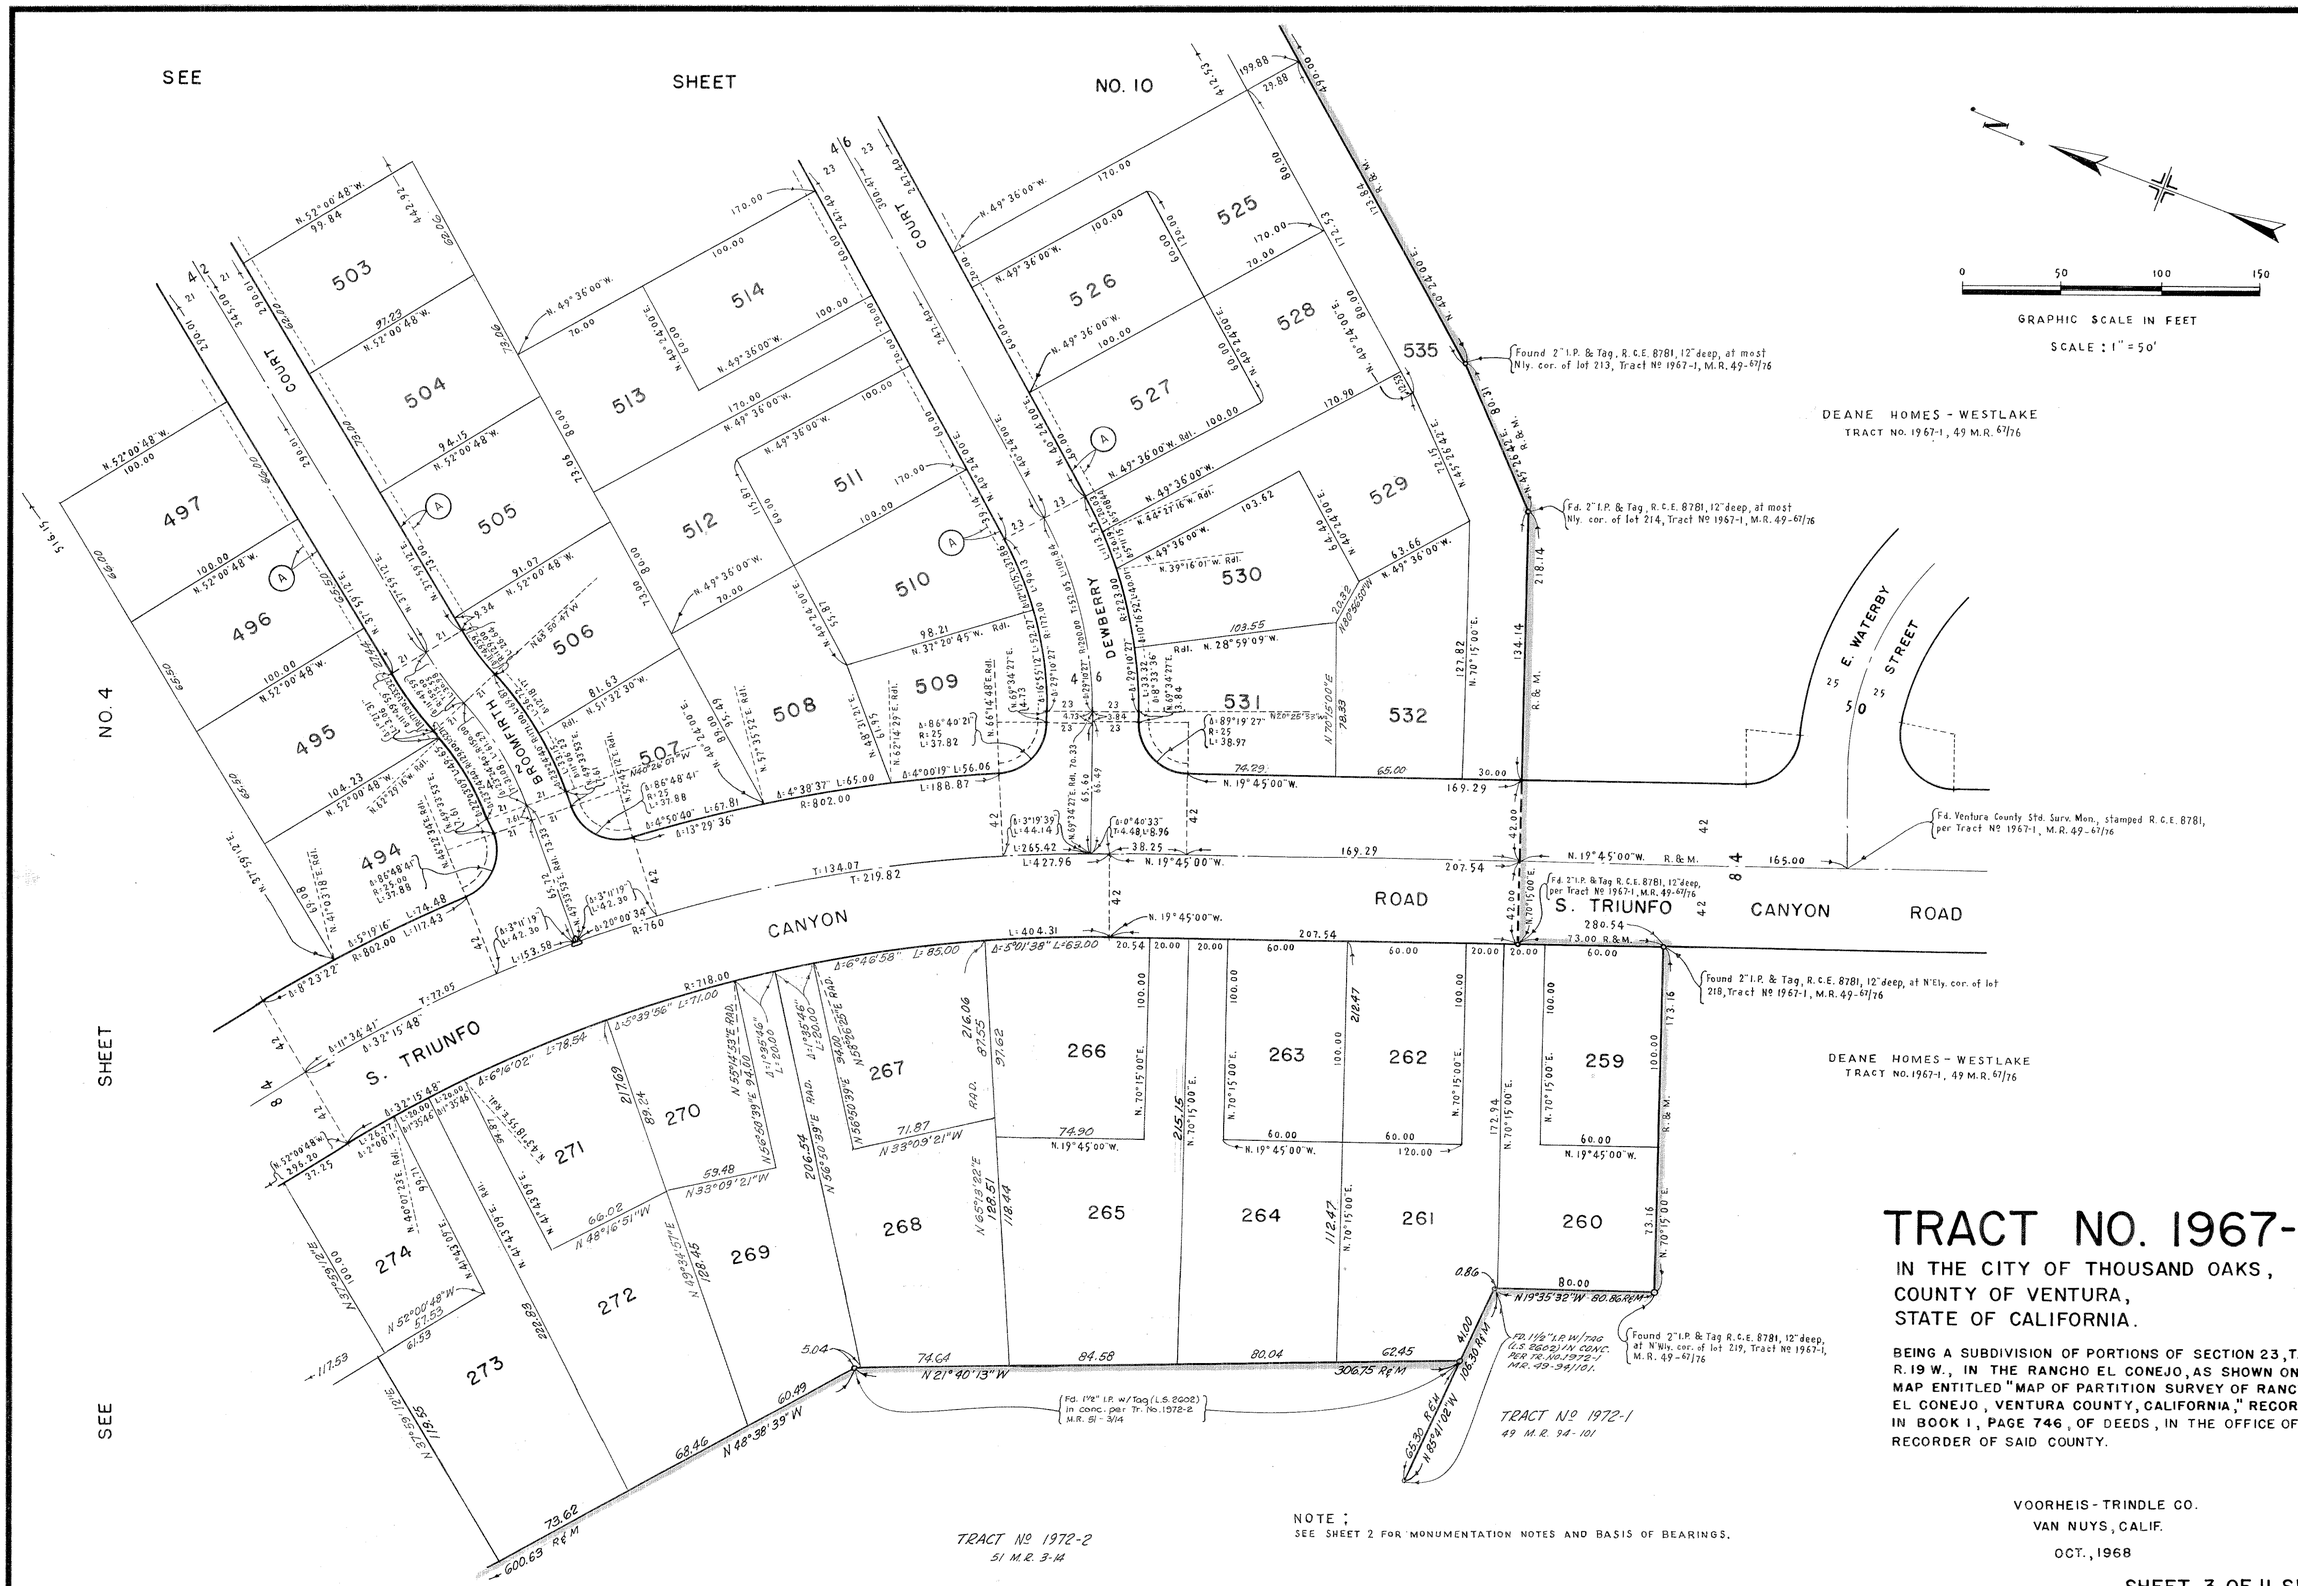

TRACT NO. 1967-2


IN THE CITY OF THOUSAND OAKS,
COUNTY OF VENTURA,
STATE OF CALIFORNIA.

BEING A SUBDIVISION OF PORTIONS OF SECTION 23, T.1N., R.19W., IN THE RANCHO EL CONEJO, AS SHOWN ON A MAP ENTITLED "MAP OF PARTITION SURVEY OF RANCHO EL CONEJO, VENTURA COUNTY, CALIFORNIA," RECORDED IN BOOK 1, PAGE 746, OF DEEDS, IN THE OFFICE OF THE RECORDER OF SAID COUNTY.

NOTE ;
SEE SHEET 2 FOR MONUMENTATION NOTES AND BASIS OF BEARINGS.

VOORHEIS - TRINDLE CO.
VAN NUYS, CALIF.
OCT., 1968

SHEET 3 OF 11 SHEETS

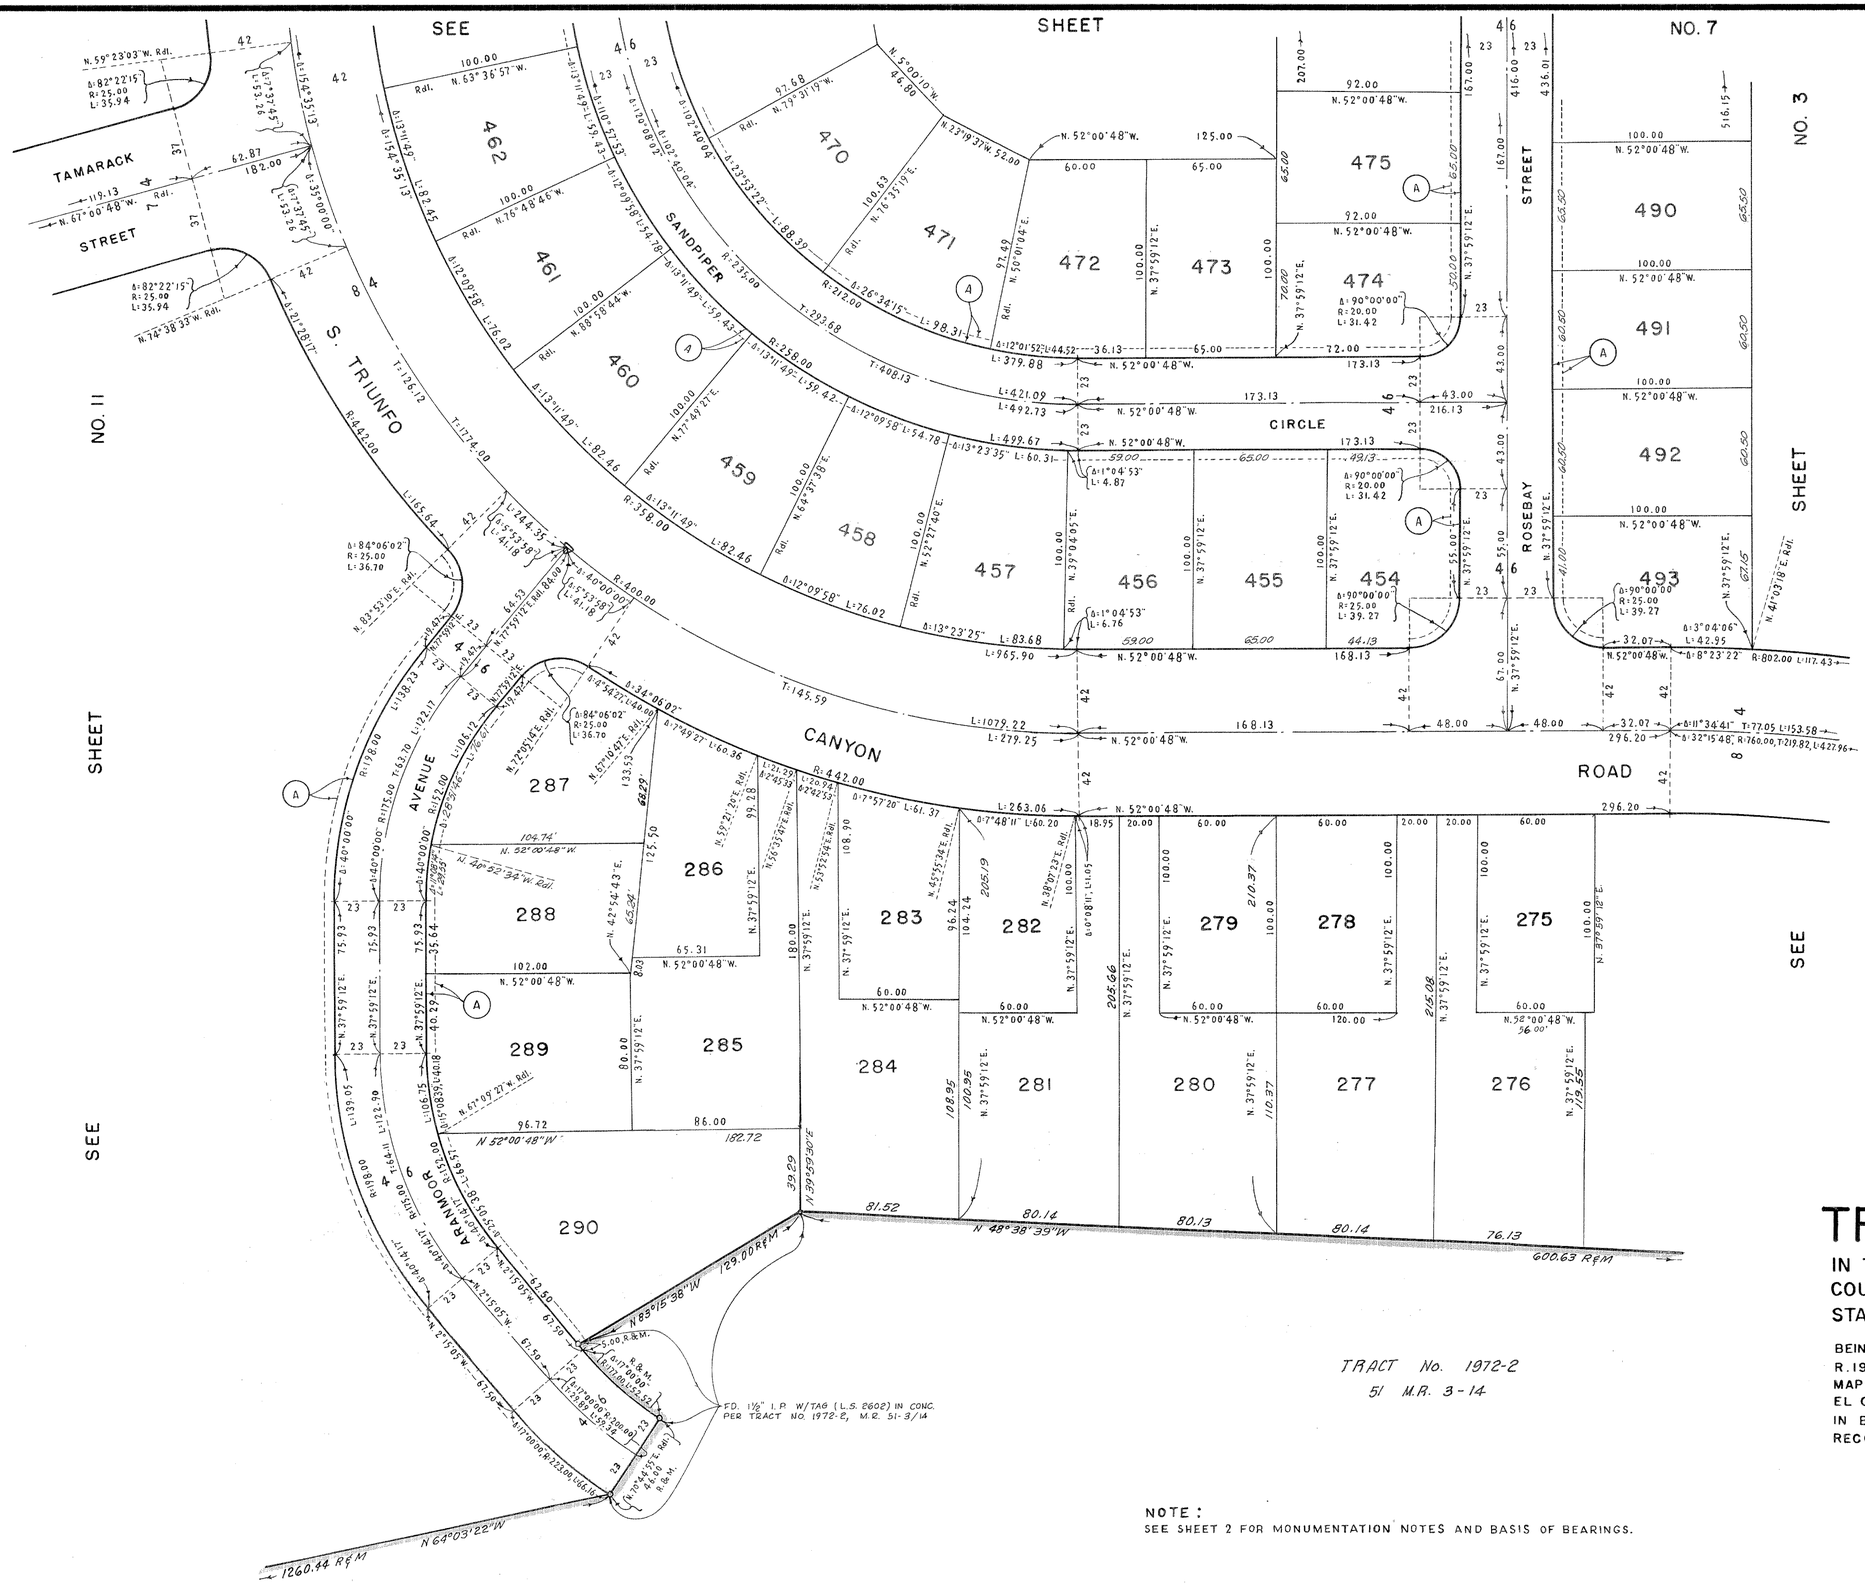

TRACT NO. 1967-2


IN THE CITY OF THOUSAND OAKS,
COUNTY OF VENTURA,
STATE OF CALIFORNIA.


BEING A SUBDIVISION OF PORTIONS OF SECTION 23, T.1N., R.19W., IN THE RANCHO EL CONEJO, AS SHOWN ON A MAP ENTITLED "MAP OF PARTITION SURVEY OF RANCHO EL CONEJO, VENTURA COUNTY, CALIFORNIA," RECORDED IN BOOK 1, PAGE 746, OF DEEDS, IN THE OFFICE OF THE RECORDER OF SAID COUNTY.


NOTE :
SEE SHEET 2 FOR MONUMENTATION NOTES AND BASIS OF BEARINGS.

VOORHEIS-TRINDLE CO.
VAN NUYS, CALIF.

OCT., 1968

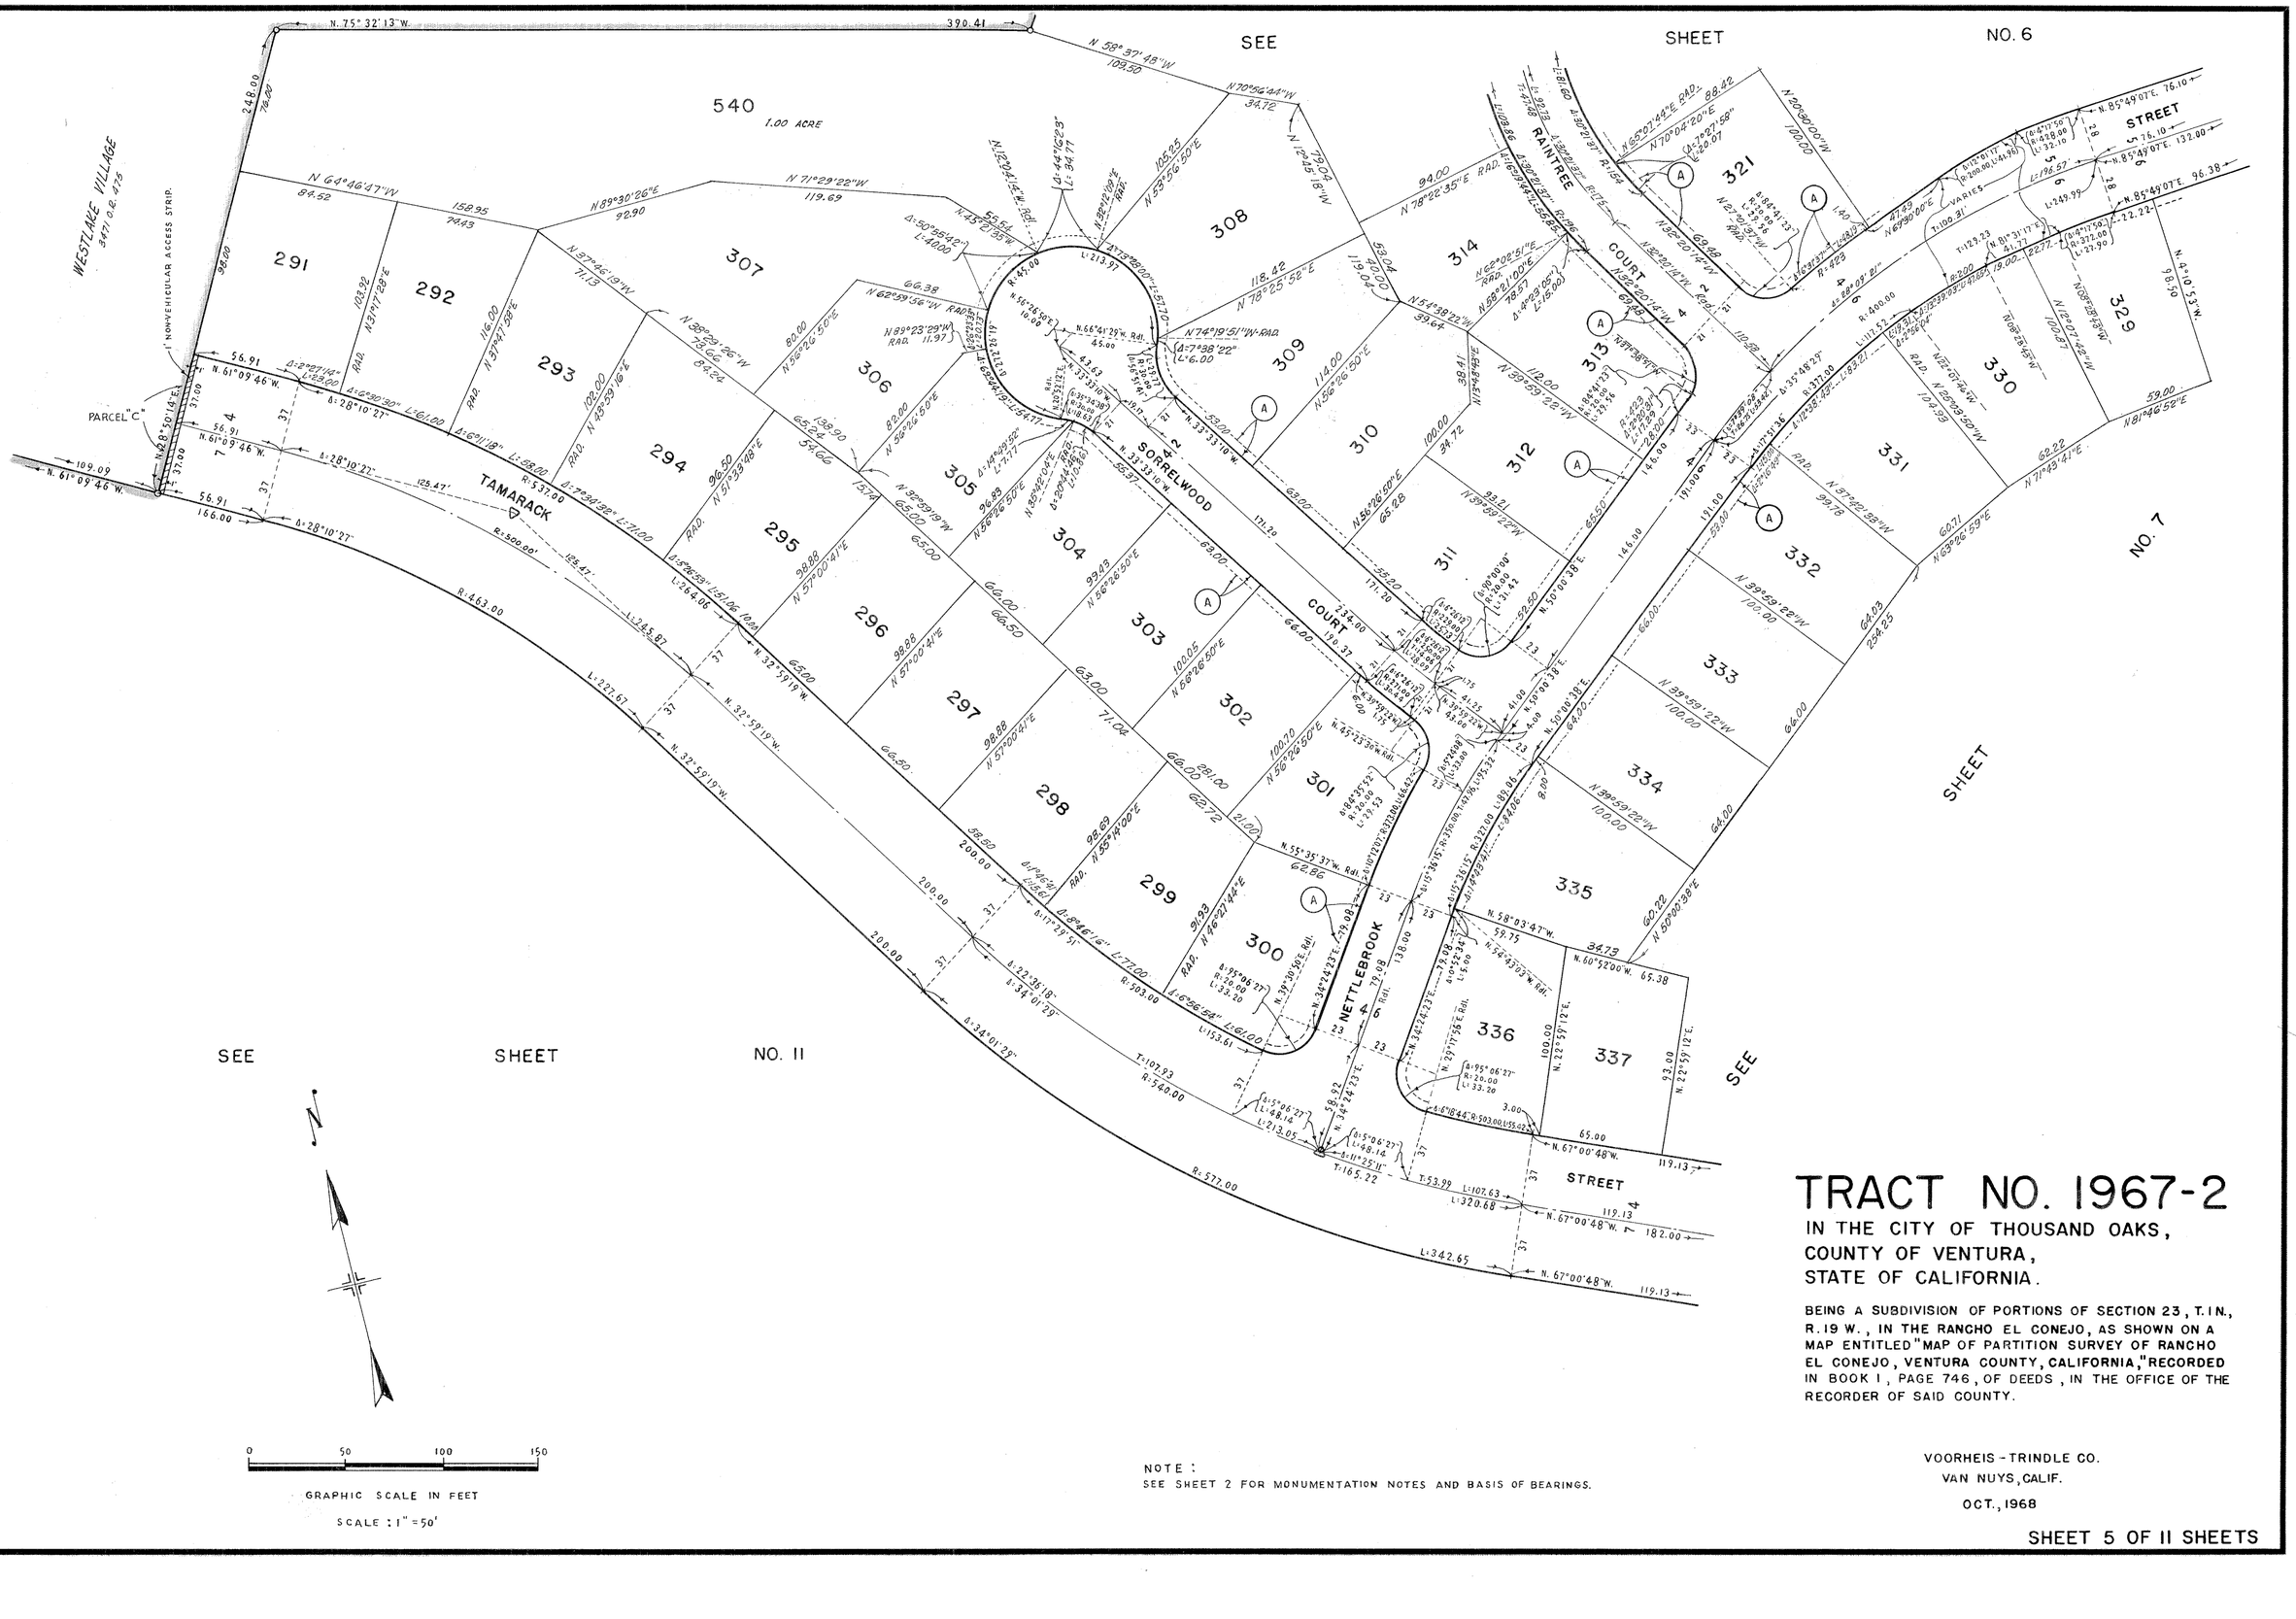
SEE SHEET NO. 6
SEE SHEET NO. 7
SEE SHEET NO. 11
SEE
WESTLAKE VILLAGE
3471 O.R. 475
1' NONVEHICULAR ACCESS STRIP.
PARCEL "C"
540
1.00 ACRE
291
292
293
294
295
296
297
298
299
300
301
302
303
304
305
306
307
308
309
310
311
312
313
314
321
329
330
331
332
333
334
335
336
337
TAMARACK
SORRELWOOD
NETTLEBROOK
RAINTREE
COURT
COURT
STREET
STREET
N. 75° 32' 13" W. 390.41
N. 59° 37' 48" W. 109.50
N 70°56'44"W 34.76
N 64°46'47"W 84.52
158.95
74.43
N 89°30'26"E 92.90
N 71°29'22"W 119.69
N 37°46'19"W 71.13
N 89°23'29"W 66.38
N 62°59'36"W
N 78°22'35"E
N 65°07'44"E
N 70°04'20"E
N 20°30'00"W 100.00
N 85°49'07"E 76.10
N 85°49'07"E 132.00
N 85°49'07"E 96.38
N 4°10'53"W 96.38
N 61°09'46"W 109.09
N 28°50'14"E 248.09
N 61°09'46"W 56.91
N 61°09'46"W 56.91
N 28°50'14"E 37.00
N 61°09'46"W 166.00
N 28°50'14"E 96.00
N 28°50'14"E 76.00

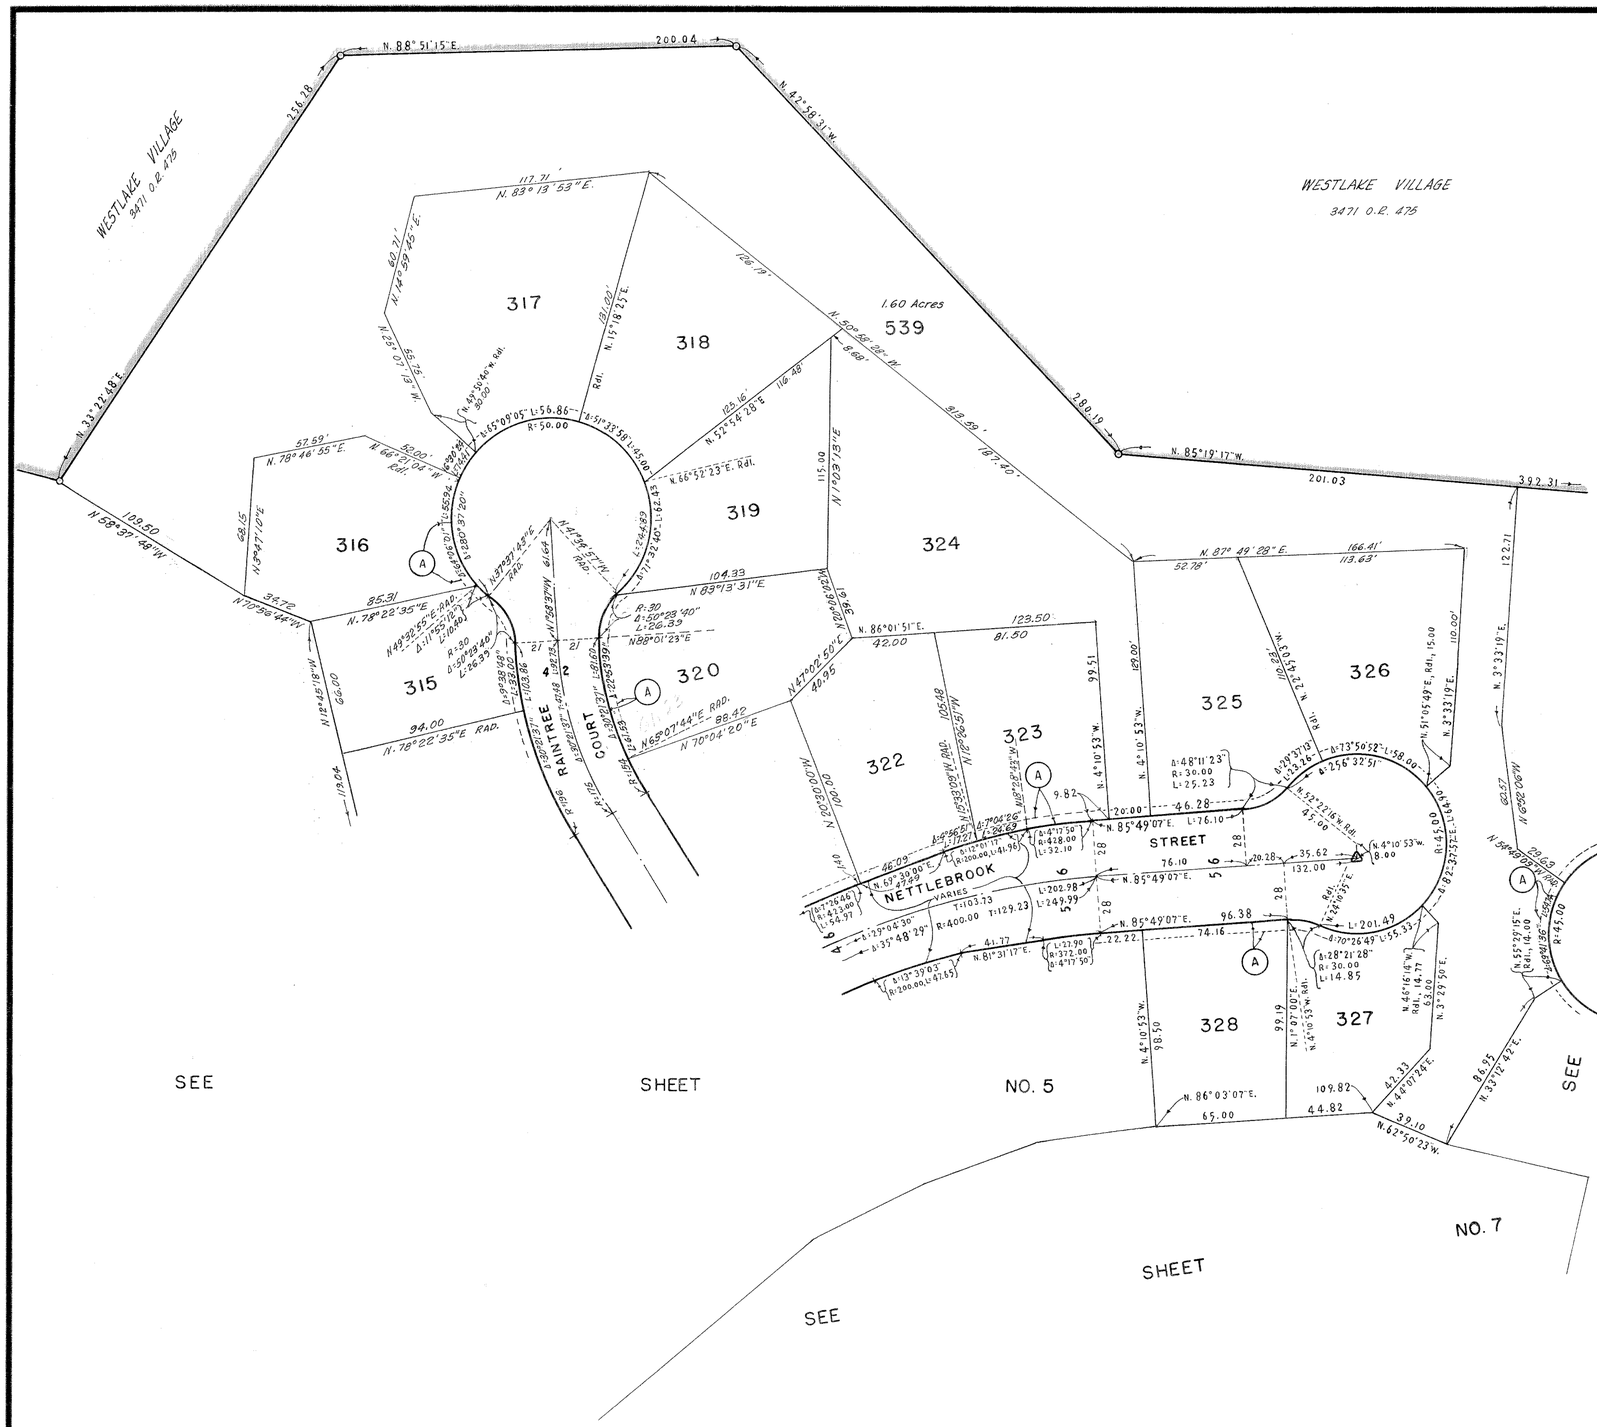

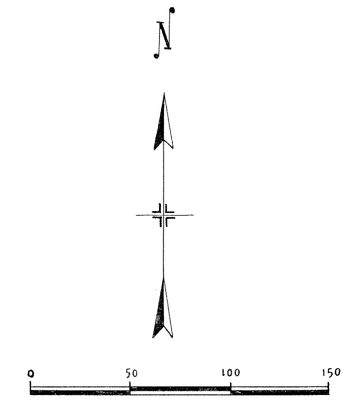

TRACT NO. 1967-2


IN THE CITY OF THOUSAND OAKS,
COUNTY OF VENTURA,
STATE OF CALIFORNIA.

BEING A SUBDIVISION OF PORTIONS OF SECTION 23, T.1N., R.19W., IN THE RANCHO EL CONEJO, AS SHOWN ON A MAP ENTITLED "MAP OF PARTITION SURVEY OF RANCHO EL CONEJO, VENTURA COUNTY, CALIFORNIA," RECORDED IN BOOK 1, PAGE 746, OF DEEDS, IN THE OFFICE OF THE RECORDER OF SAID COUNTY.

NOTE :
SEE SHEET 2 FOR MONUMENTATION NOTES AND BASIS OF BEARINGS.

VOORHEIS - TRINDLE CO.
VAN NUYS, CALIF.
OCT., 1968

SHEET 6 OF 11 SHEETS

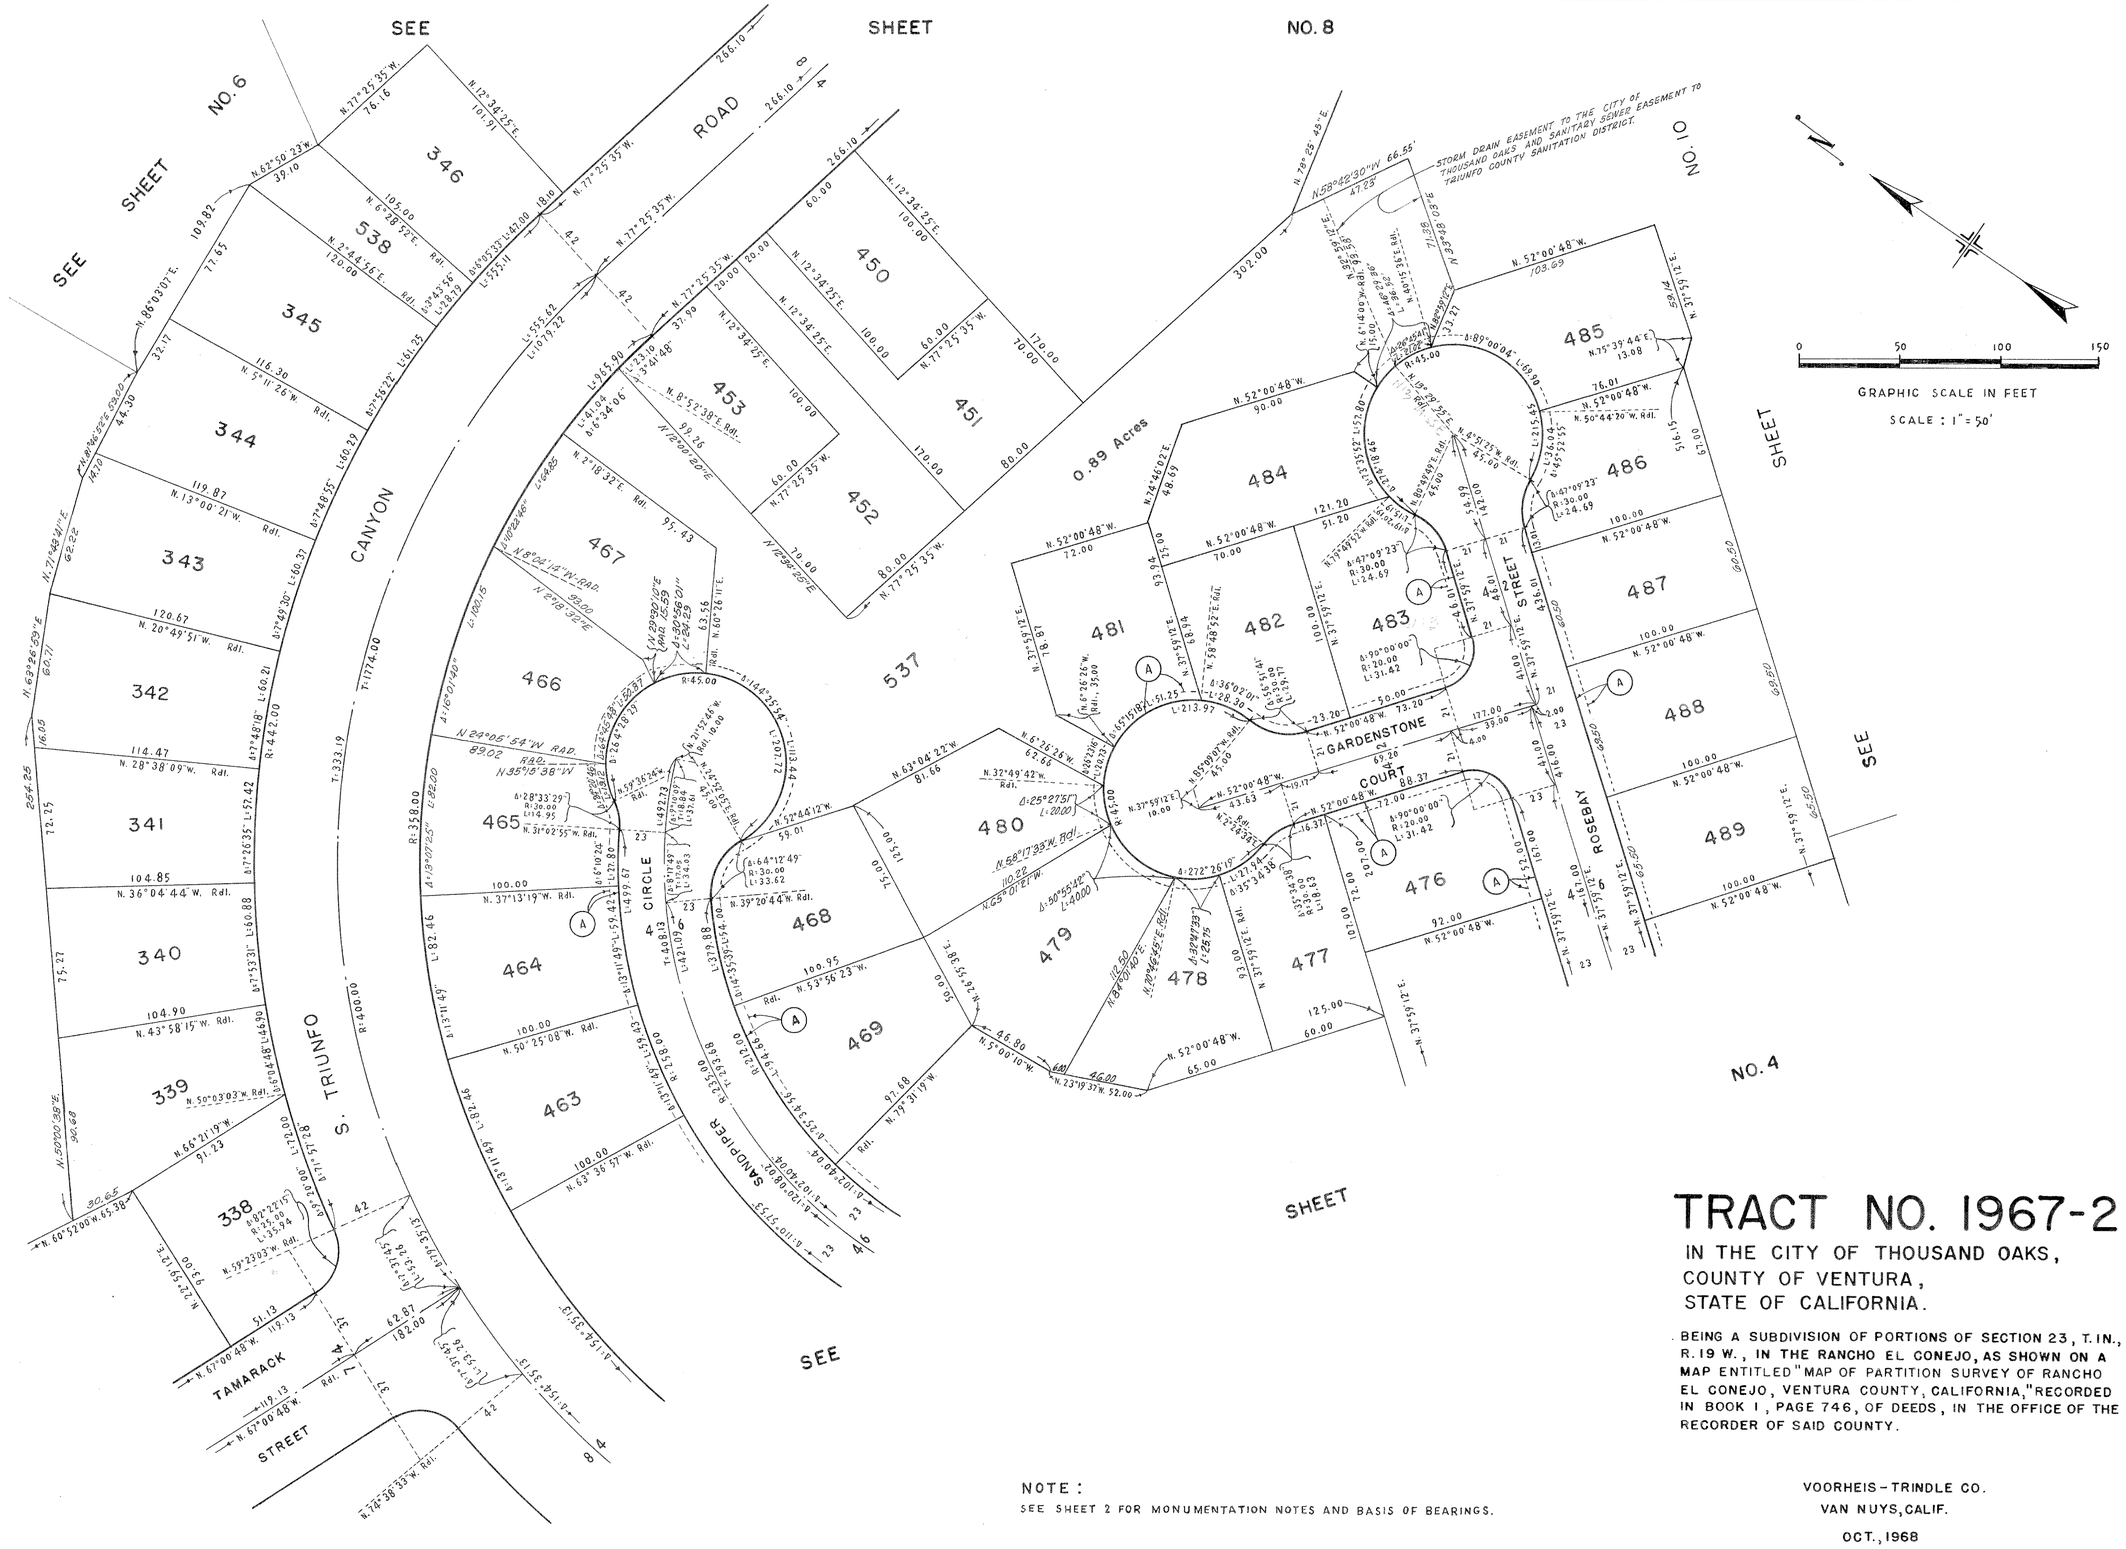

TRACT NO. 1967-2

IN THE CITY OF THOUSAND OAKS,
COUNTY OF VENTURA,
STATE OF CALIFORNIA.

BEING A SUBDIVISION OF PORTIONS OF SECTION 23, T. IN., R. 19 W., IN THE RANCHO EL CONEJO, AS SHOWN ON A MAP ENTITLED "MAP OF PARTITION SURVEY OF RANCHO EL CONEJO, VENTURA COUNTY, CALIFORNIA," RECORDED IN BOOK 1, PAGE 746, OF DEEDS, IN THE OFFICE OF THE RECORDER OF SAID COUNTY.

NOTE :
SEE SHEET 2 FOR MONUMENTATION NOTES AND BASIS OF BEARINGS.

VOORHEIS - TRINDLE CO.
VAN NUYS, CALIF.
OCT., 1968

SHEET 7 OF 11 SHEETS
















0 50 100 150

GRAPHIC SCALE IN FEET

SCALE : 1" = 50'

NOTE :
SEE SHEET 2 FOR MONUMENTATION NOTES AND BASIS OF BEARINGS.


TRACT NO. 1967-2

IN THE CITY OF THOUSAND OAKS, COUNTY OF VENTURA, STATE OF CALIFORNIA.

BEING A SUBDIVISION OF PORTIONS OF SECTION 23, T.1N., R.19W., IN THE RANCHO EL CONEJO, AS SHOWN ON A MAP ENTITLED "MAP OF PARTITION SURVEY OF RANCHO EL CONEJO, VENTURA COUNTY, CALIFORNIA," RECORDED IN BOOK 1, PAGE 746, OF DEEDS, IN THE OFFICE OF THE RECORDER OF SAID COUNTY.

VOORHEIS-TRINDLE CO.
VAN NUYS, CALIF.

OCT., 1968

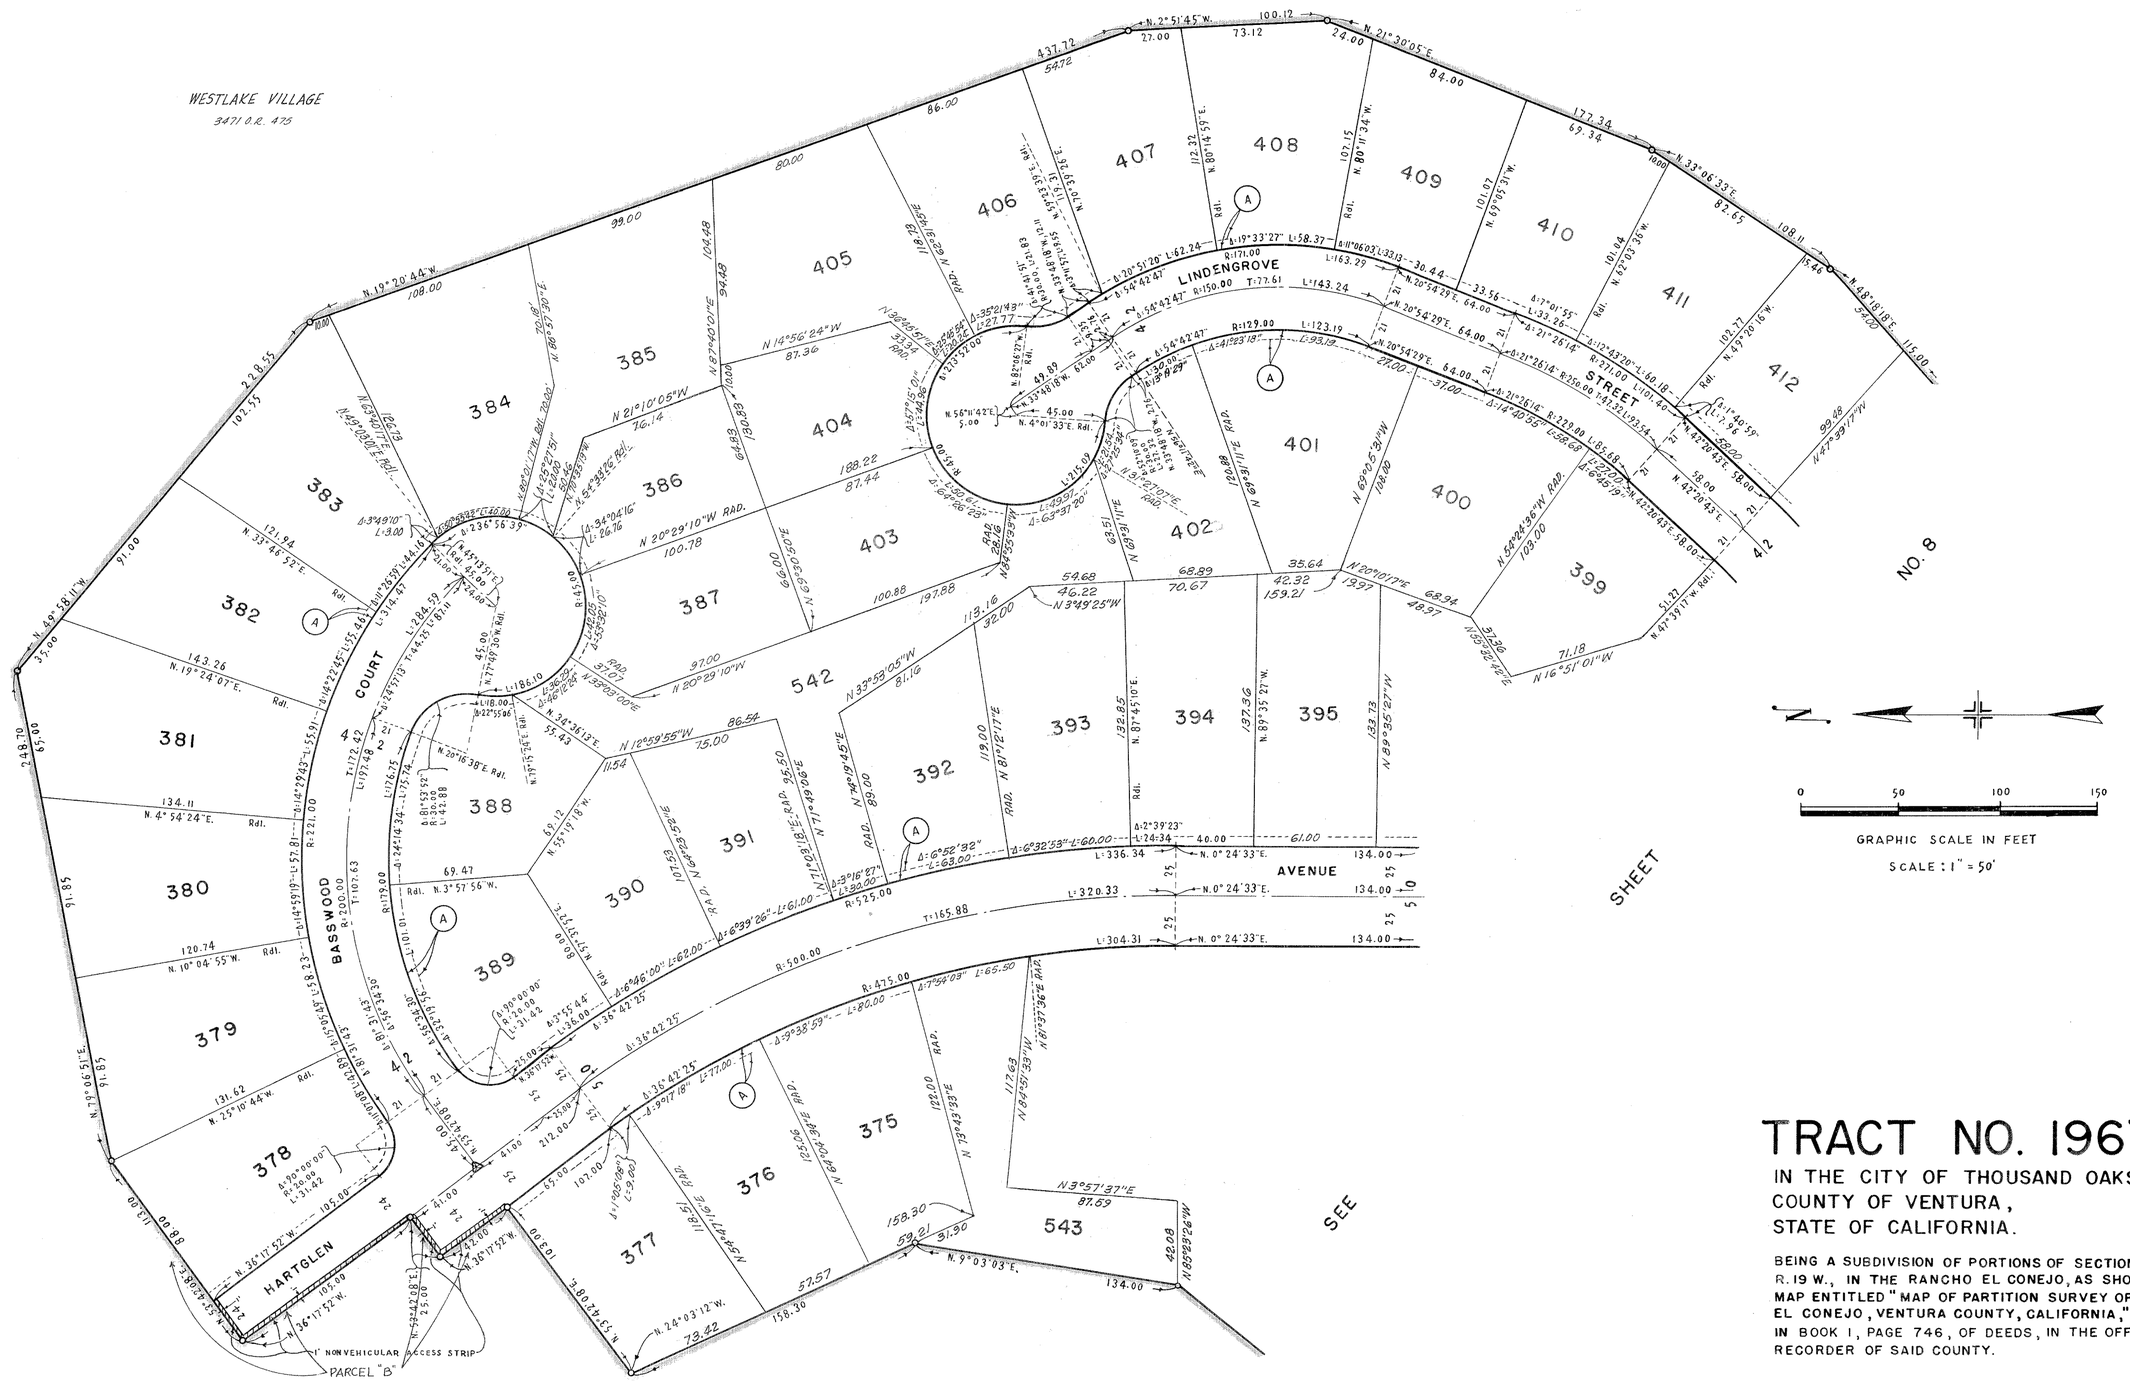

TRACT NO. 1967-2

IN THE CITY OF THOUSAND OAKS,
COUNTY OF VENTURA,
STATE OF CALIFORNIA.

BEING A SUBDIVISION OF PORTIONS OF SECTION 23, T.1N., R.19W., IN THE RANCHO EL CONEJO, AS SHOWN ON A MAP ENTITLED "MAP OF PARTITION SURVEY OF RANCHO EL CONEJO, VENTURA COUNTY, CALIFORNIA," RECORDED IN BOOK 1, PAGE 746, OF DEEDS, IN THE OFFICE OF THE RECORDER OF SAID COUNTY.

VOORHEIS - TRINDLE CO.
VAN NUYS, CALIF.
OCT., 1968

NOTE :
SEE SHEET 2 FOR MONUMENTATION NOTES AND BASIS OF BEARINGS.

TRACT NO. 1967-2


IN THE CITY OF THOUSAND OAKS,
COUNTY OF VENTURA,
STATE OF CALIFORNIA.

BEING A SUBDIVISION OF PORTIONS OF SECTION 23, T.1N., R.19W., IN THE RANCHO EL CONEJO, AS SHOWN ON A MAP ENTITLED "MAP OF PARTITION SURVEY OF RANCHO EL CONEJO, VENTURA COUNTY, CALIFORNIA," RECORDED IN BOOK 1, PAGE 746, OF DEEDS, IN THE OFFICE OF THE RECORDER OF SAID COUNTY.

VOORHEIS-TRINDLE CO.
VAN NUYS, CALIF.
OCT., 1968

NOTE:
SEE SHEET 2 FOR MONUMENTATION NOTES AND BASIS OF BEARINGS.

GRAPHIC SCALE IN FEET
SCALE: 1" = 50'

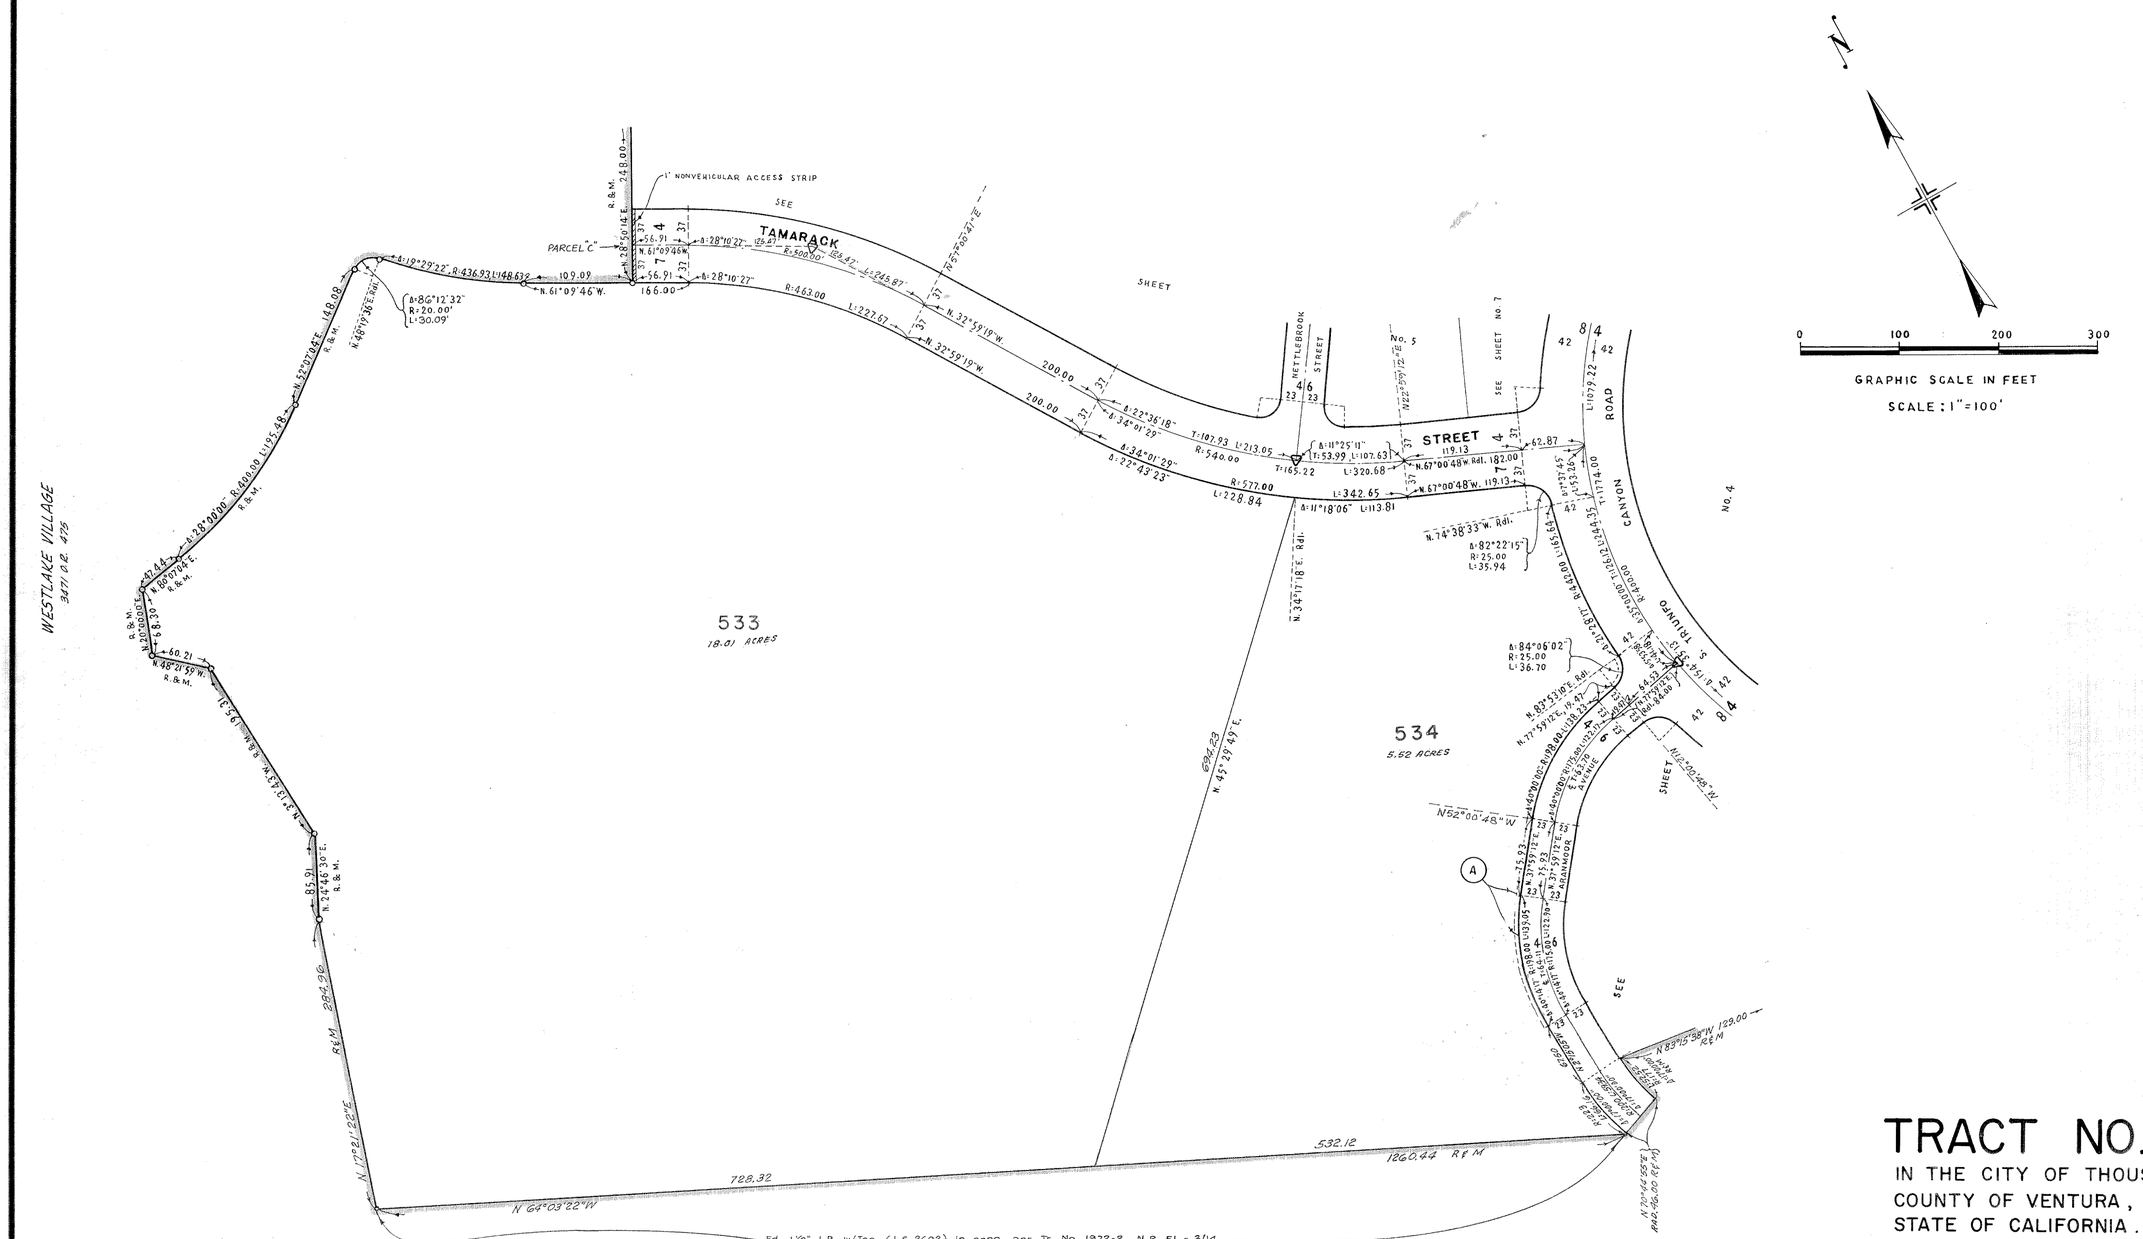

0 100 200 300

GRAPHIC SCALE IN FEET

SCALE : 1"=100'

TRACT No. 1972-2
51 M.R. 3-14

TRACT NO. 1967-2

IN THE CITY OF THOUSAND OAKS,
COUNTY OF VENTURA,
STATE OF CALIFORNIA.

BEING A SUBDIVISION OF PORTIONS OF SECTION 23, T.1N., R.19 W., IN THE RANCHO EL CONEJO, AS SHOWN ON A MAP ENTITLED "MAP OF PARTITION SURVEY OF RANCHO EL CONEJO, VENTURA COUNTY, CALIFORNIA," RECORDED IN BOOK 1, PAGE 746, OF DEEDS, IN THE OFFICE OF THE RECORDER OF SAID COUNTY.

NOTE :
SEE SHEET 2 FOR MONUMENTATION NOTES AND BASIS OF BEARINGS.

VOORHEIS-TRINDLE CO.
VAN NUYS, CALIF.
OCT, 1968

SHEET 11 OF 11 SHEETS